

# CERTIFICATE OF LOCATION OF GOVERNMENT CORNER


NORTHEAST Corner of Section 6, Township 108, Range 41, 5TH P.M.

STATE OF MINNESOTA, County of MURRAY

At the corner location shown on the sketch:

- On \_\_\_\_\_ found a \_\_\_\_\_  
DATE
- left monument as found,  lowered monument,  removed monument (explain)
- On 5/7/14 placed a 1" pipe w/seal #43844  
DATE

## SKETCH OF REFERENCE TIES

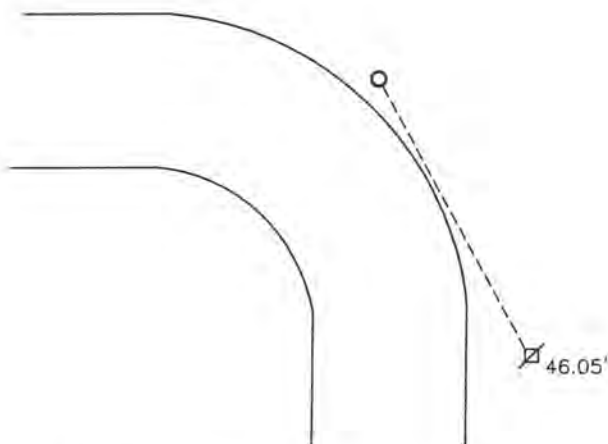

Minnesota State Plane Coordinate  
 System Murray County Datum  
 NAD83 (1996)

N: 226938.416  
 E: 490043.966

Nail and survey marker in utility pole SE 46.05'

Statement of evidence relative to this corner location is on back of page.

I hereby certify that this document and the data contained herein was prepared by me or under my direct supervision

*Paul Smith* 1/14/15  
SIGNATURE DATE

Registration No. 43844

- Land Surveyor,  Professional Engineer  
 County Surveyor,  County Engineer

## OFFICE OF THE COUNTY RECORDER

County of \_\_\_\_\_

I hereby certify that this document was filed in the Co. Recorders office at \_\_\_\_\_ .M on the \_\_\_\_\_ day of FEB 20 2015 A.D. 20 \_\_\_\_\_

County Recorder *Evelyn C. Larson*

By \_\_\_\_\_, Deputy

DOCUMENT NO. \_\_\_\_\_

## Statement of Evidence

In 1858, W.J. Neely did the original survey of the north line of the township.

On October 15, 1910, J.W. Woolstencroft showed a stone recorded at the corner.

On July 3, 1931, (No name) recorded stone with ties at the corner.

On May 7, 2014, Bueltel-Moseng Land Surveying dug with a backhoe. Found nothing. Set a 1" iron pipe with seal #43844 by holding to the north line between the southwest corner of Section 32-109-41 and southeast corner of Section 33-109-41, and projecting occupational line to the north. Ties from 1931 survey fit very well.